


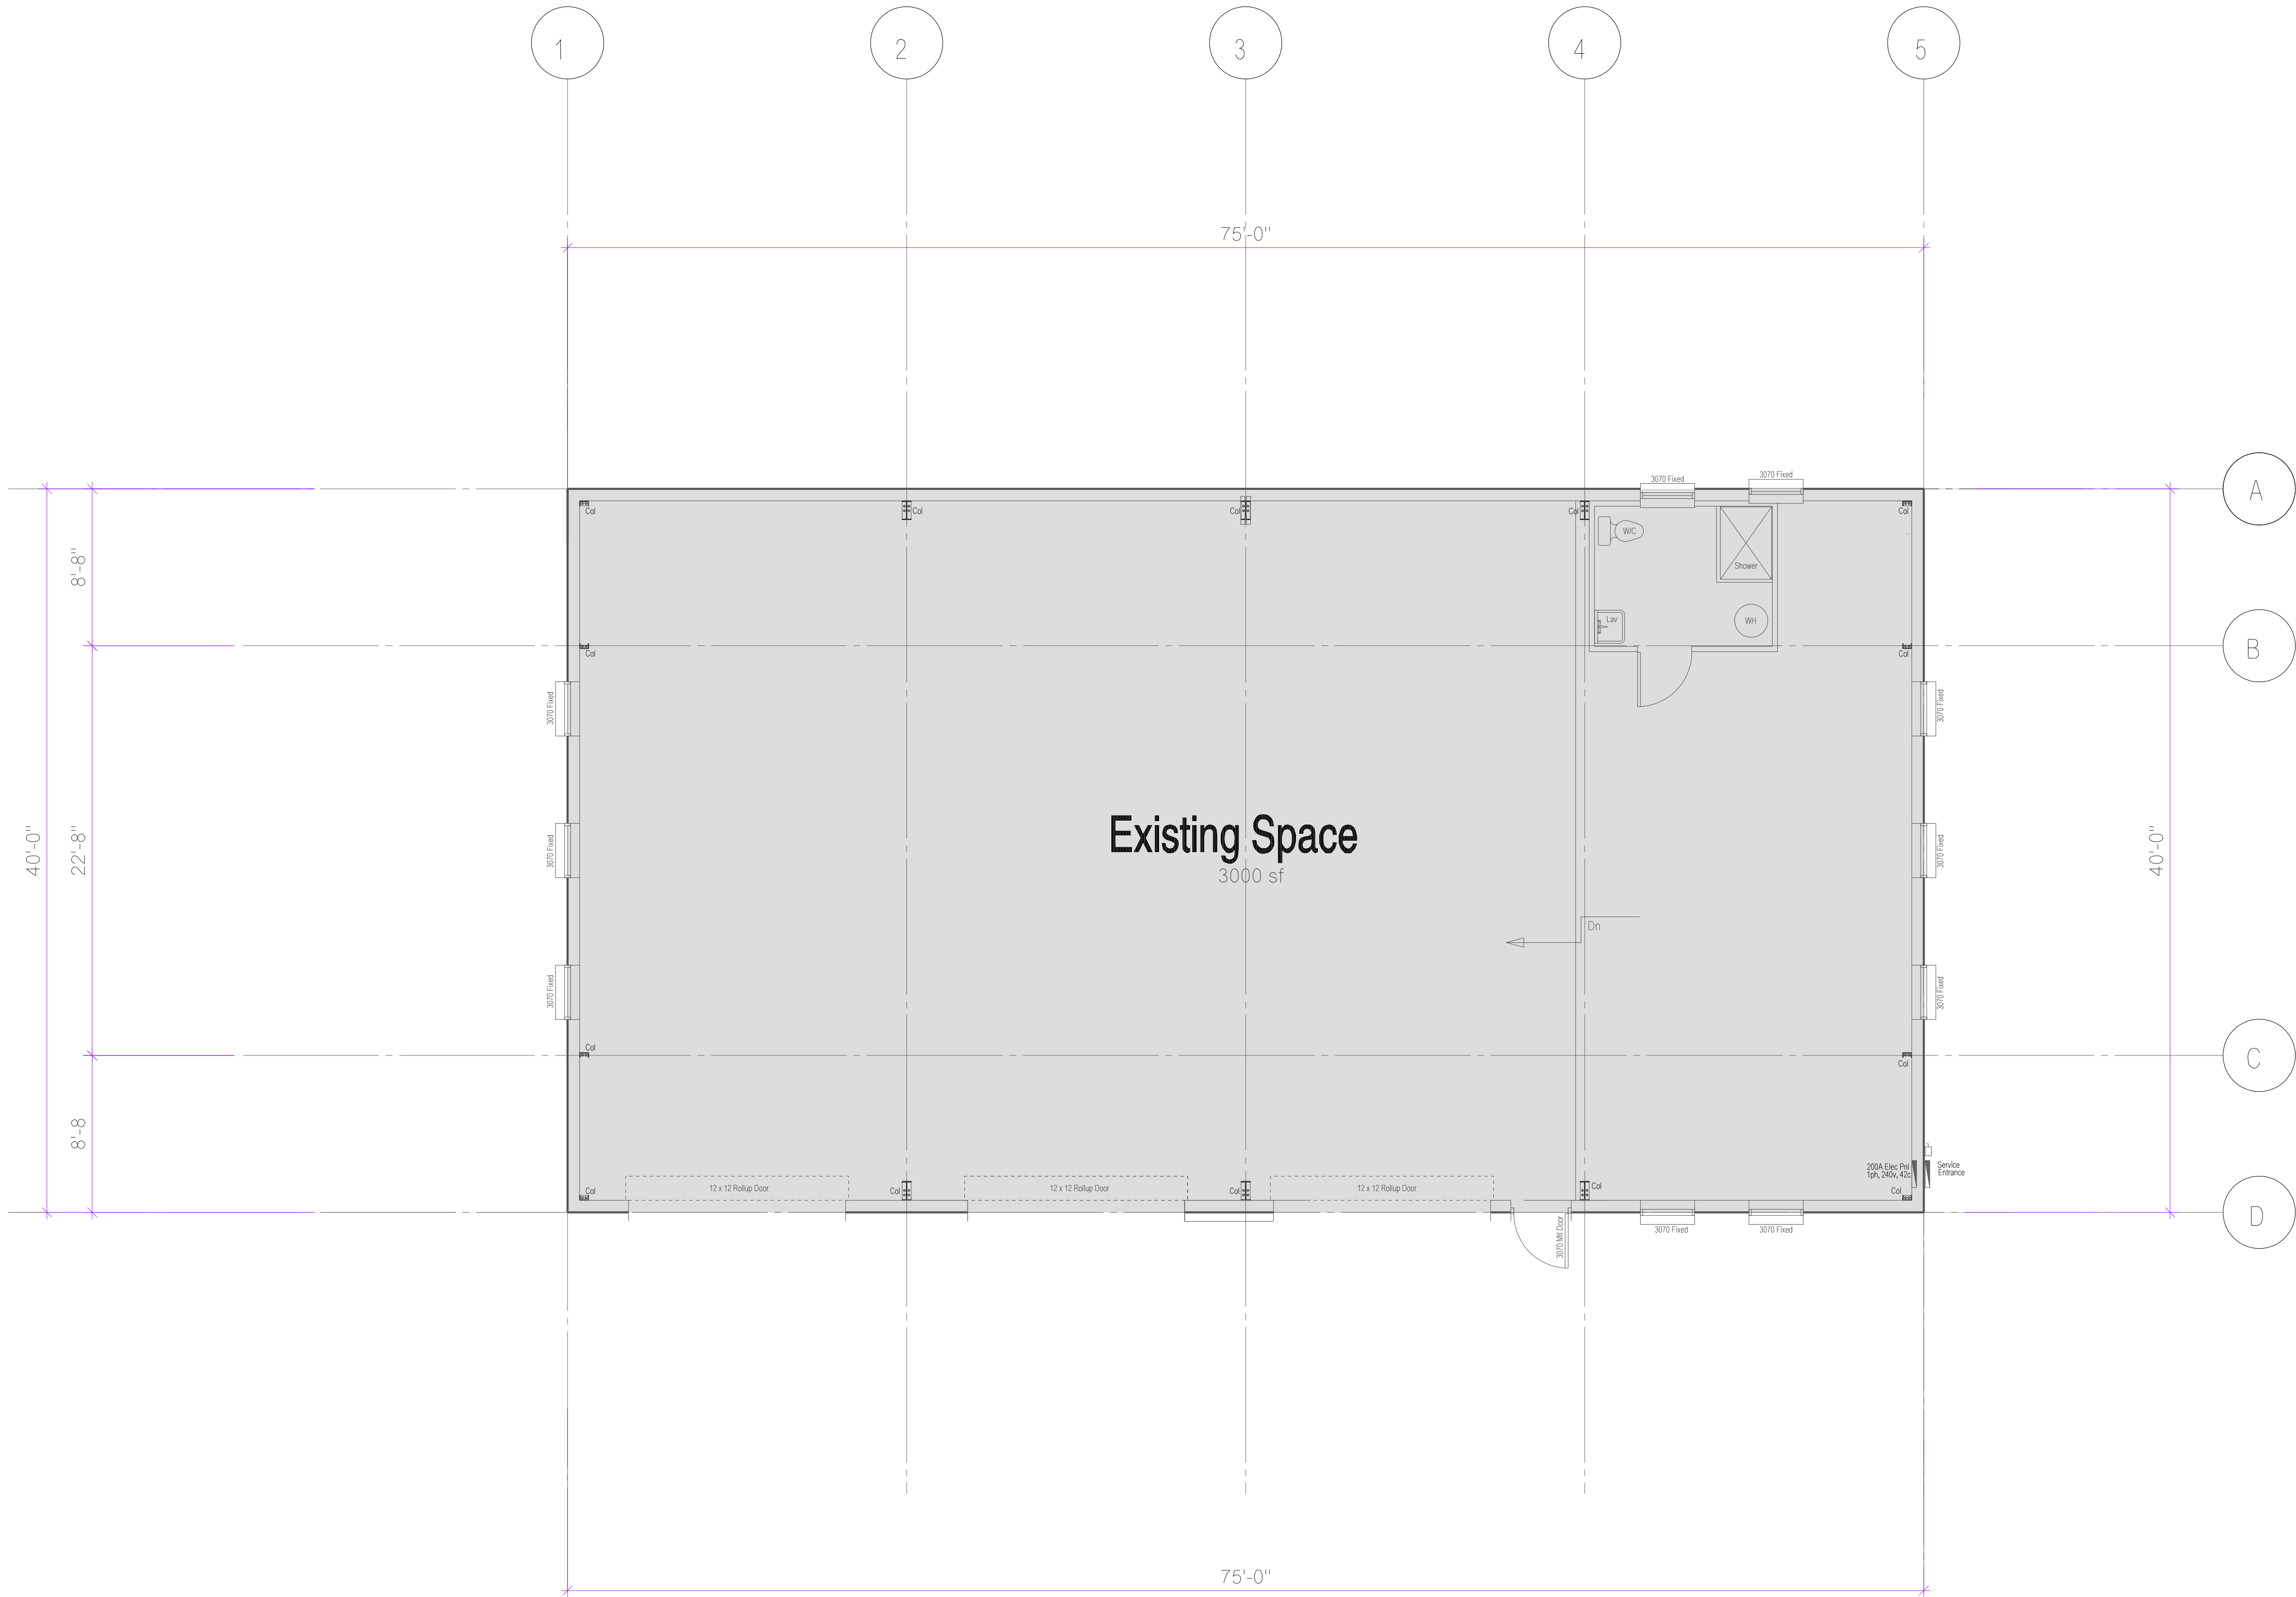

As-Built Floor Plan

Scale 3/16"=1'-0"

NOTICE
This document & all plans, specifications, and other information contained herein are the exclusive property of SDA Design. The document is delivered and accepted in trust and on express condition that neither it nor the information in it will be copied, reproduced, or delivered to others in whole or in part except with express written permission from SDA Design.

INDEX CODE
sda277 ob100

REVISIONS	
NO.	DATE & DESCRIPTION

DATE OF DWG.
12 Aug. 2026

PRINTING DATE

SHEET NUMBER
AB100
1 of 1